

Date: Thursday, 3/2/2006 3:08:26 PM
 User: Jim Johnston

Process Sheet

Customer	: CU-DAR001 Dart Helicopters Services	Drawing Name	: BRACKET ASSEMBLY
Job Number	: 26042		
Estimate Number	: 10291		
P.O. Number	: N/A	Part Number	: D3183044
This Issue	: 3/2/2006	S.O. No.	: N/A
Prsht Rev.	: NC	Drawing Number	: D3183 REV C1
First Issue	: N/A	Project Number	: N/A
Previous Run	: 25557D	Drawing Revision	: C1
		Material	: N/A
Written By	: <u>SEE COMMENT BELOW</u>	Due Date	: 3/30/2006
Checked & Approved By	: <u>06.03.02</u>	Qty:	8 Um: Each
Comment	: Est Rev: Pick: A 04.02.18 New issue KJ/DS		

Additional Product

Job Number:



Seq. #:	Machine Or Operation:	Description :
---------	-----------------------	---------------

1.0	M174B2000X01500	17-4 SS Bar
-----	-----------------	-------------



Comment: Qty.: 0.4812 f(s)/Unit Total : 3.8497 f(s)

Material: 17-4 SS Bar per AMS 5604/5643

(M17-4-B1.500x02.000)

Identify for D3183-4

Batch: M15438 x 8

u 06.03.12

En 06.03.106

8

2.0	BAND SAW	BAND SAW
-----	----------	----------



Comment: BAND SAW 1.500"

Cut blanks: (1.000" x 2.000") 5.500" long

En 06.03.106

8

3.0	HAAS1	HAAS CNC VERTICAL MACHINING #1
-----	-------	--------------------------------



Comment: HAAS CNC VERTICAL MACHINING #1

1-Machine D3183-4 as per Folio FA322 and Dwg D3183

Identify as D3183-4

2-Deburr

3-Scribe batch number

SD / JL 06.03.11

4.0	QC2	INSPECT PARTS AS THEY COME OFF MACHINE
-----	-----	--



Comment: INSPECT PARTS AS THEY COME OFF MACHINE

SD / JL 06.03.11

PTD

Dart Aerospace Ltd

W/O:		WORK ORDER CHANGES					
DATE	STEP	PROCEDURE CHANGE	By	Date	Qty	Approval Chief Eng / Prod Mgr	Approval QC Inspector

Part No: _____ PAR #: _____ Fault Category: _____ NCR: Yes ☒ No ☐ DQA: ☒ ☐ Date: 06/03/15
 QA: N/C Closed: _____ Date: _____

NCR:		WORK ORDER NON-CONFORMANCE (NCR)						
DATE	STEP	Description of NC Section A	Corrective Action Section B			Verification Section C	Approval Chief Eng	Approval QC Inspector
			Initial Chief Eng	Action Description Chief Eng	Sign & Date			
06-03-14	3	- 1 part scrapped, origin on 4th axis wasn't set properly causing part to be .020 thinner on one half.		- scrapped + replace	J.L. 06.03.14			

NOTE: Date & initial all entries

Date: Thursday, 3/2/2006 3:08:26 PM
User: Kim Johnston

Process Sheet

Customer: CU-DAR001 Dart Helicopters Services

Drawing Name: BRACKET ASSEMBLY

Job Number: 26042

Part Number: D3183044

Job Number:



Seq. #:

Machine Or Operation:

Description :

5.0

QC8

SECOND CHECK



Comment: SECOND CHECK

MS

06/03/14

6.0

D312121

Bolt



Comment: Qty.: 2.0000 Each(s)/Unit Total: 16.0000 Each(s)

Pick:

Qty Part Number

Description Batch

2 D3121-21

Bolt B25560

J.L 06.03.14

7.0

D3183045

Bearing Assembly



Comment: Qty.: 2.0000 Each(s)/Unit Total: 16.0000 Each(s)

Pick:

Qty Part Number

Description Batch

2 D3183-045 Bearing Ass

B25562

J.L 06.03.14

8.0

SMALL FAB 1

SMALL & MEDIUM FAB RESOURCE 1



Comment: SMALL & MEDIUM FAB RESOURCE 1

Assemble D3183-043 as per Dwg D3183.

J.L 06.03.14

9.0

QC5

INSPECT WORK TO CURRENT STEP



Comment: INSPECT WORK TO CURRENT STEP

J.L / MS 06/03/14

10.0

PACKAGING 1

PACKAGING RESOURCE #1



Comment: PACKAGING RESOURCE #1

Identify and Stock

Location: 51412

C206/03/15

(8)

11.0

DC

DOCUMENT CONTROL



Comment: DOCUMENT CONTROL

Inspection Level 21

D 06/03/15

(9)

Job Completion



W 06/03/15

Dart Aerospace Ltd

W/O:		WORK ORDER CHANGES					
DATE	STEP	PROCEDURE CHANGE	By	Date	Qty	Approval Chief Eng / Prod Mgr	Approval QC Inspector

Part No: _____ PAR #: _____ Fault Category: _____ NCR: Yes No DQA: _____ Date: _____

QA: N/C Closed: _____ Date: _____

NCR:		WORK ORDER NON-CONFORMANCE (NCR)						
DATE	STEP	Description of NC Section A	Corrective Action Section B			Verification Section C	Approval Chief Eng	Approval QC Inspector
			Initial Chief Eng	Action Description Chief Eng	Sign & Date			


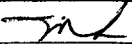
NOTE: Date & initial all entries


DART AEROSPACE LTD		Work Order:
Description: Bracket		Part Number: D3183-4
Inspection Dwg: D3183	Rev: C	Page 1 of 1

FIRST ARTICLE INSPECTION CHECKLIST


☒ First Article ☐ Prototype

Drawing Dimension	Tolerance	Actual Dimension	Accept	Reject	Method of Inspection	Comments
R0.190	+/-0.030	.1875	/			
R0.063	+/-0.010	R.063	/			
0.182	+/-0.010	.186	/			
0.070	+/-0.010	.071	/			
0.100	+/-0.010	.103	/			
Ø0.201 x 0.100	+/-0.010	Ø.203 x .100	/			
0.182	+/-0.010	.184	/			
5.32	+/-0.030	5.325	/			
5.036	+/-0.010	5.038	/			
2.120	+/-0.010					Cannot measure
1.290	+/-0.010	1.288	/			
0.365	+/-0.010	.365	/			
0.218	+/-0.010	.212	/			
1.030	+/-0.010	1.031	/			
1.90	+/-0.030	1.890	/			
1.012	+/-0.010	1.015	/			
Ø0.201 x 0.100	+/-0.010	Ø.203 x .100	/			
0.182	+/-0.010	.183	/			
0.786	+/-0.010	.790	/			
Ø0.392	+0.002/-0.000	Ø.392	/			
R0.19	+/-0.030	.203	/			
3.954	+/-0.010	3.955	/			
0.162	+/-0.010	.165	/			
R0.19	+/-0.030	R.203	/			
R0.25	+/-0.030	R.250	/			
4.26	+/-0.030	4.262	/			
2.800	+/-0.030	2.805	/			
Calculated dimension						
0.162	+/-0.010	.165	/			
0.615	+/-0.010	.612	/			
0.435	+/-0.010	.435	/			
0.200	+/-0.010	.205	/			
0.381	+/-0.010	.384	/			
0.032	+/-0.010	.032	/			

Measured by: 	Audited by: 	Prototype Approval:	N/A
Date: 06.03.	Date: 06/03/16	Date:	N/A

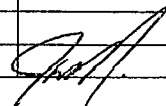Rev	Date	Change	Revised by	Approved
A	03.11.12	New Issue	KJ/RF	
B	04.03.15	Changes as per revision C	KJ/JLM/RF	
C	04.06.15	Dimension 2.800 was 2.080; removed 1.155, 0.36 dimensions	KJ/JLM	


RELEASED

 04-06-27




DESIGN #	DRAWN BY CP	DART AEROSPACE LTD HAWKESBURY, ONTARIO, CANADA	
CHECKED #	APPROVED #	DRAWING NO. D3183	REV. C SHEET 1 OF 4
DATE 04.02.17		TITLE BRACKET ASSEMBLY	SCALE 1:1
A.	03.01.24	NEW ISSUE	
B.	03.06.17	REMOVE BEARING; 1.012 WS 0.882	
C.	04.02.17	ADD -045/-9; 0.182 WAS 0.431	
CI	04.11.09	0.830 WAS 0.850	

RELEASED
04.03.01

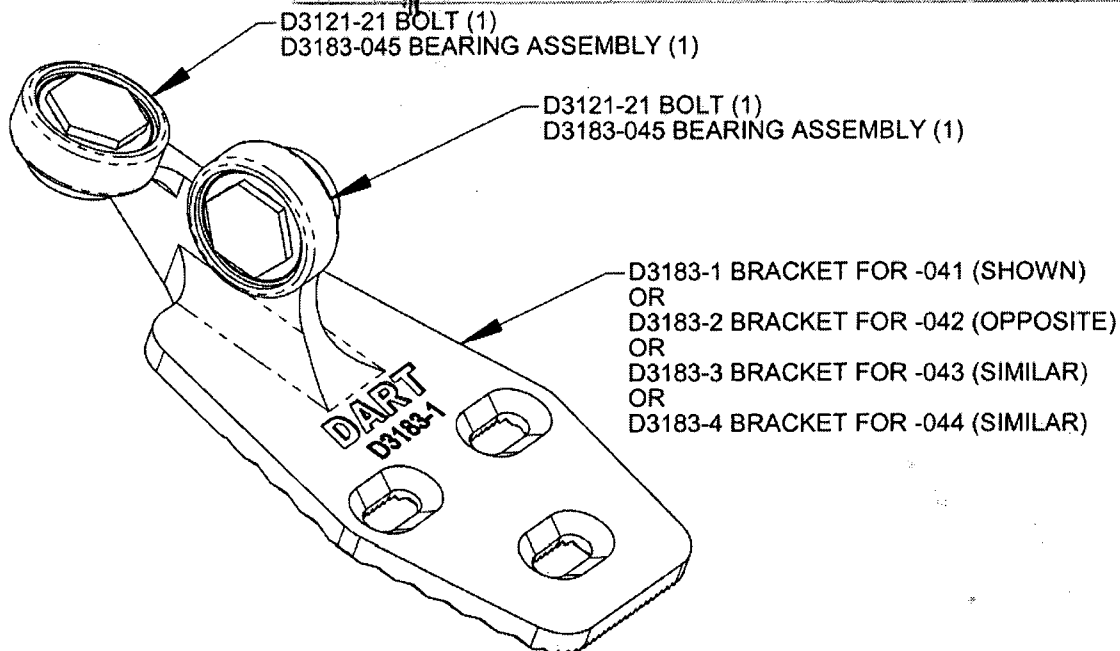


D3183-041 BRACKET ASSEMBLY (SHOWN)
D3183-042 BRACKET ASSEMBLY (OPPOSITE)
D3183-043 BRACKET ASSEMBLY (SIMILAR)
D3183-044 BRACKET ASSEMBLY (SIMILAR)

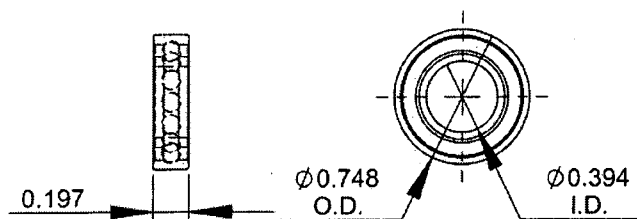

D3183-5 BEARING:
SPECIFICATION CONTROL DRAWING

- 1) SINGLE ROW, DEEP GROOVE, CONRAD TYPE, SHIELDED
- 2) POSSIBLE SUPPLIER: NSK P/N 6800ZZ
- 3) ALL DIMENSIONS ARE IN INCHES

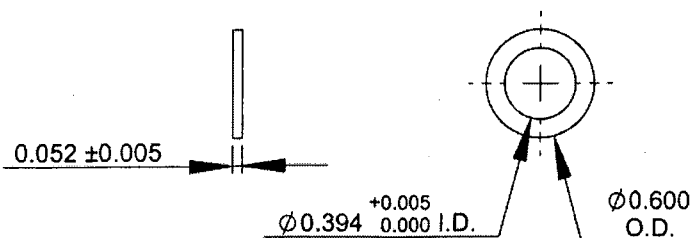

D3183-7 WASHER

- 1) MATERIAL: AISI 303 ROUND BAR (M303R) ANNEALED
- 2) BREAK ALL SHARP EDGES 0.005 TO 0.010
- 3) TOLERANCES ARE PER DART QSI 018 UNLESS OTHERWISE NOTED
- 4) ALL DIMENSIONS ARE IN INCHES

SHOP COPY

RETURN TO
ENGINEERING

CONTROLLED COPY
SUBJECT TO AMENDMENT
WITHOUT NOTICE

WORK ORDER


NO. 26042

COPYRIGHT © 2003 BY DART AEROSPACE LTD.

THIS DOCUMENT IS PRIVATE AND CONFIDENTIAL AND IS SUPPLIED ON THE EXPRESS CONDITION THAT IT IS NOT TO BE USED FOR ANY PURPOSE OR COPIED OR COMMUNICATED TO ANY OTHER PERSON WITHOUT WRITTEN PERMISSION FROM DART AEROSPACE LTD.




DESIGN <i>[Signature]</i>	DRAWN BY <i>[Signature]</i>	DART AEROSPACE LTD HAWKESBURY, ONTARIO, CANADA	
CHECKED <i>[Signature]</i>	APPROVED <i>[Signature]</i>	DRAWING NO. D3183	REV. C SHEET 4 OF 4
DATE 04.02.17	TITLE BRACKET ASSEMBLY		SCALE 1:1

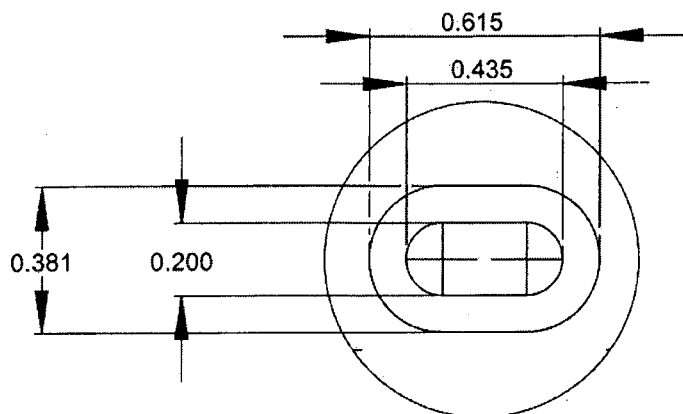

DETAIL A (2 : 1)

RELEASED
04.03.01

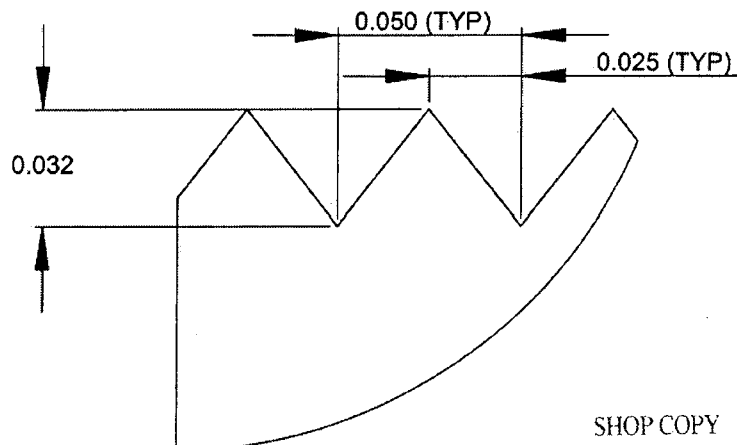

DETAIL B (20 : 1)


SHOP COPY
RETURN TO
ENGINEERING
UNCONTROLLED COPY
SUBJECT TO AMENDMENT
WITHOUT NOTICE
WORK ORDER
NO. 26042

D3183-9 CAP

- 1) MATERIAL: DELRIN ROD, Ø1.00
(REF DART SPEC. M-DELRIN-R1.00)
- 2) TOLERANCES ARE PER DART QSI 018
UNLESS OTHERWISE NOTED
- 3) ALL DIMENSIONS ARE IN INCHES

D3183-045 BEARING ASSEMBLY

- 1) ASSEMBLE D3183-5 BEARING AND
D3183-9 CAP

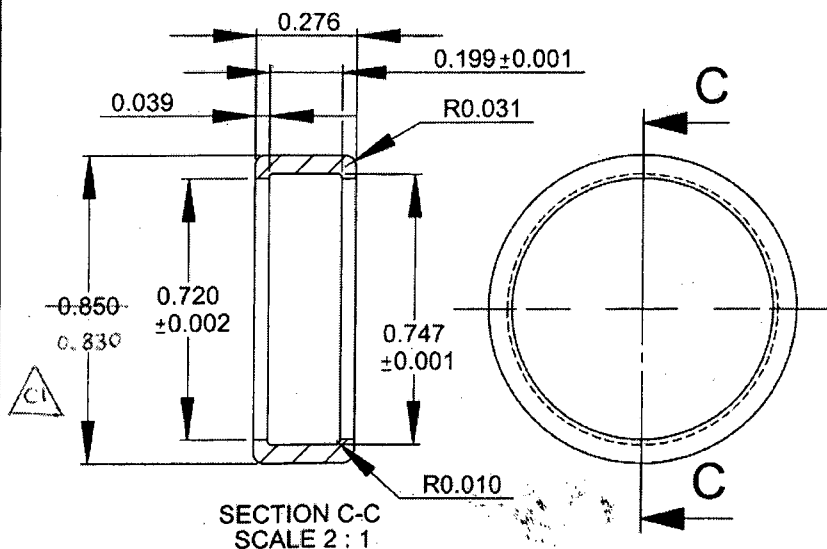


COPYRIGHT © 2003 BY DART AEROSPACE LTD.

THIS DOCUMENT IS PRIVATE AND CONFIDENTIAL AND IS SUPPLIED ON THE EXPRESS CONDITION THAT IT IS NOT TO BE USED FOR ANY PURPOSE OR COPIED OR COMMUNICATED TO ANY OTHER PERSON WITHOUT WRITTEN PERMISSION FROM DART AEROSPACE LTD.



DESIGN	DRAWN BY	DART AEROSPACE LTD
CHECKED	APPROVED	HAWKESBURY, ONTARIO, CANADA
DATE	DRAWING NO.	REV. C
04.02.17	D3183	SHEET 3 OF 4
TITLE	BRACKET ASSEMBLY	SCALE
		1:2

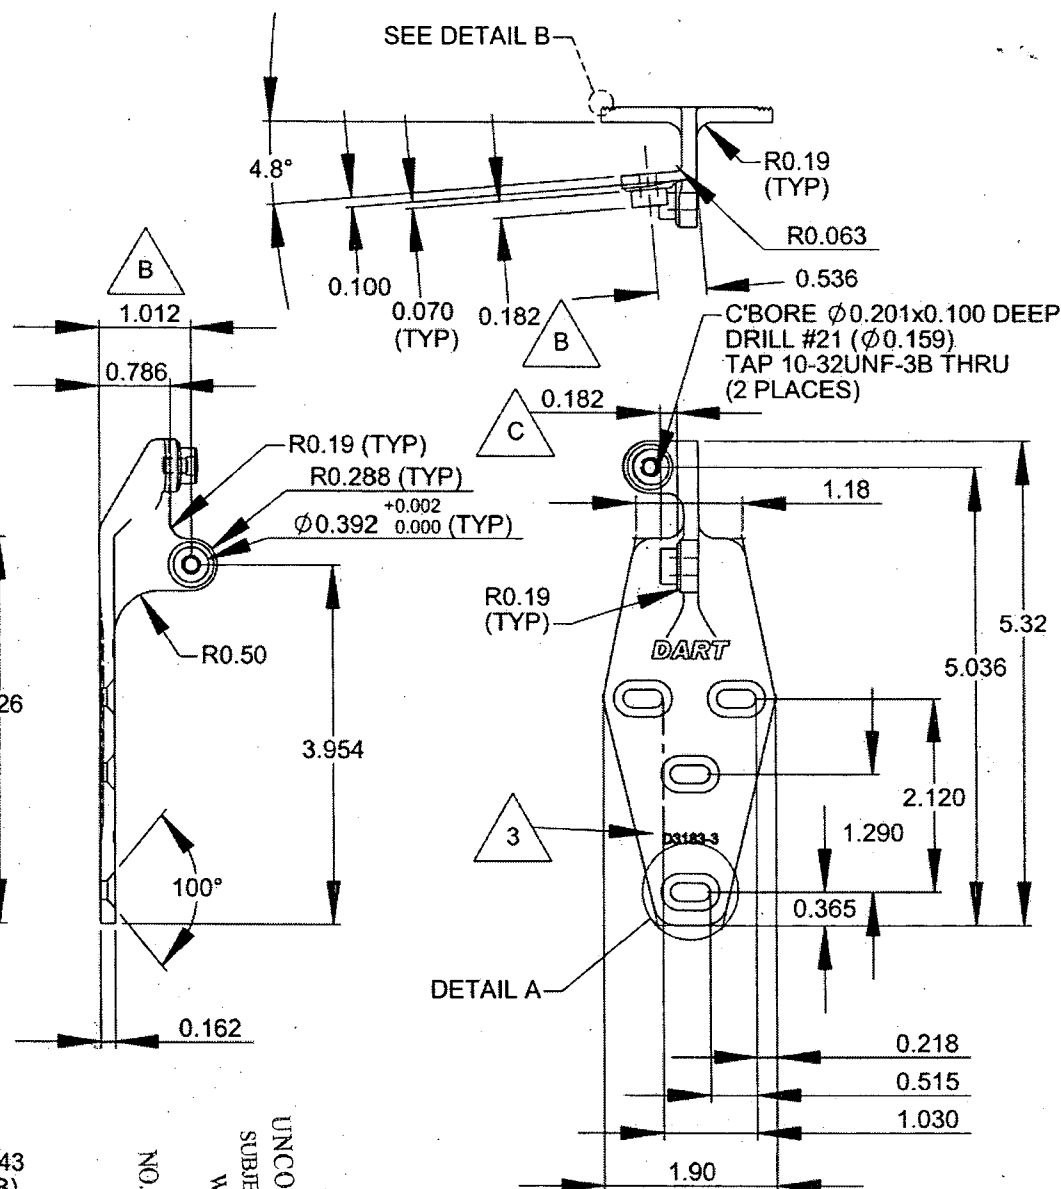

D3183-3 BRACKET SHOWN
(REPLACES BELL P/N 412-030-304-105)
D3183-4 BRACKET OPPOSITE
(REPLACES BELL P/N 412-030-304-106)

- 1) MATERIAL: 17-4 SS PER AMS 5604/5643 (REF DART SPEC. M17-4-B)
MIN ULTIMATE STRENGTH = 150 ksi
MIN YIELD STRENGTH = 100 ksi
- 2) BREAK ALL SHARP EDGES 0.005 TO 0.015
- 3) ENGRAVE DART P/N & LOGO AS SHOWN
- 4) TOLERANCES ARE PER DART QSI 018 UNLESS OTHERWISE SPECIFIED
- 5) ALL DIMENSIONS ARE IN INCHES

SHOP COPY
RETURN TO
ENGINEERING
UNCONTROLLED COPY
SUBJECT TO AMENDMENT
WITHOUT NOTICE
WORK ORDER NO. 26042





COPYRIGHT © 2003 BY DART AEROSPACE LTD.

THIS DOCUMENT IS PRIVATE AND CONFIDENTIAL AND IS SUPPLIED ON THE EXPRESS CONDITION THAT IT IS NOT TO BE USED FOR ANY PURPOSE OR COPIED OR COMMUNICATED TO ANY OTHER PERSON WITHOUT WRITTEN PERMISSION FROM DART AEROSPACE LTD.

RELEASED
24.03.01

DART

DESIGN	DRAWN BY	DART Aerospace LTD
CHECKED	APPROVED	HAWKESBURY, ONTARIO, CANADA
DATE	TITLE	REV. C
04.02.17	BRACKET ASSEMBLY	SHEET 2 OF 4
		SCALE 1:2

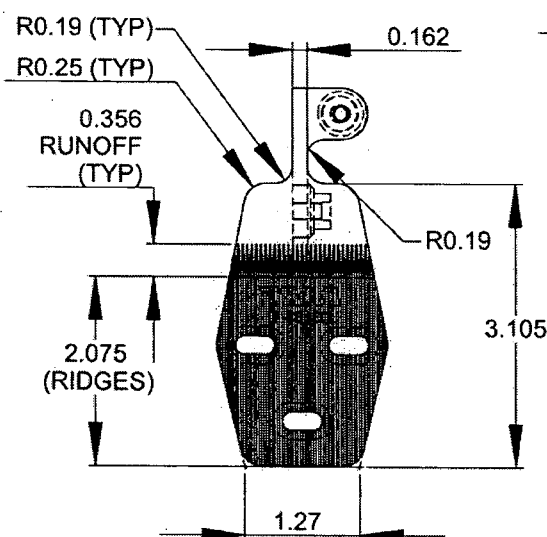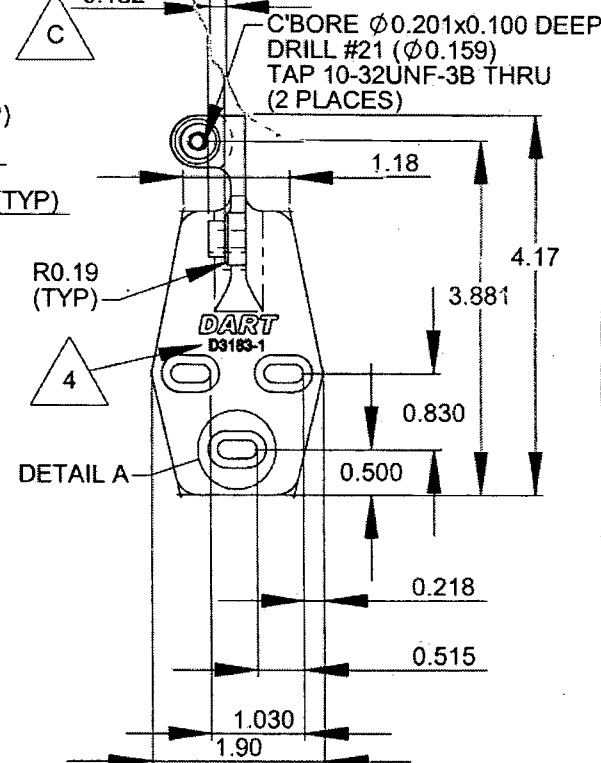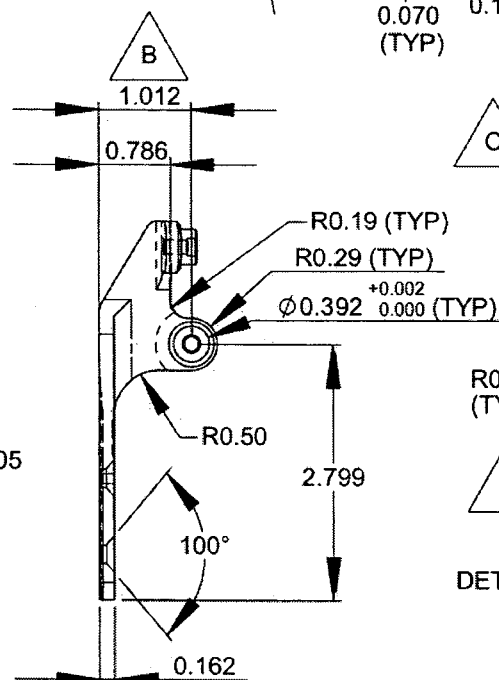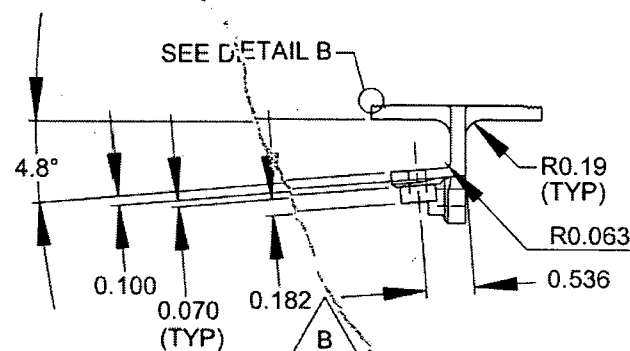RELEASED
04.03.01

D3183-1 BRACKET SHOWN
D3183-2 BRACKET OPPOSITE

- 1) D3183-1 CAN BE MADE FROM D3183-3
D3183-2 CAN BE MADE FROM D3183-4
- 2) MATERIAL: 17-4 SS PER AMS 5604/5643
(REF DART SPEC. M17-4-B)
MIN ULTIMATE STRENGTH = 150 ksi
MIN YIELD STRENGTH = 100 ksi
- 3) BREAK ALL SHARP EDGES 0.005 TO 0.015
- 4) ENGRAVE DART P/N & LOGO AS SHOWN
- 5) TOLERANCES ARE PER DART QSI 018 UNLESS OTHERWISE NOTED
- 6) ALL DIMENSIONS ARE IN INCHES

SHOP COPY
RETURN TO
ENGINEERING
UNCONTROLLED COPY
SUBJECT TO AMENDMENT
WITHOUT NOTICE
WORK ORDER
NO. 26042

COPYRIGHT © 2003 BY DART AEROSPACE LTD.

THIS DOCUMENT IS PRIVATE AND CONFIDENTIAL AND IS SUPPLIED ON THE EXPRESS CONDITION THAT IT IS NOT TO BE USED FOR ANY PURPOSE OR COPIED OR COMMUNICATED TO ANY OTHER PERSON WITHOUT WRITTEN PERMISSION FROM DART AEROSPACE LTD.

192

